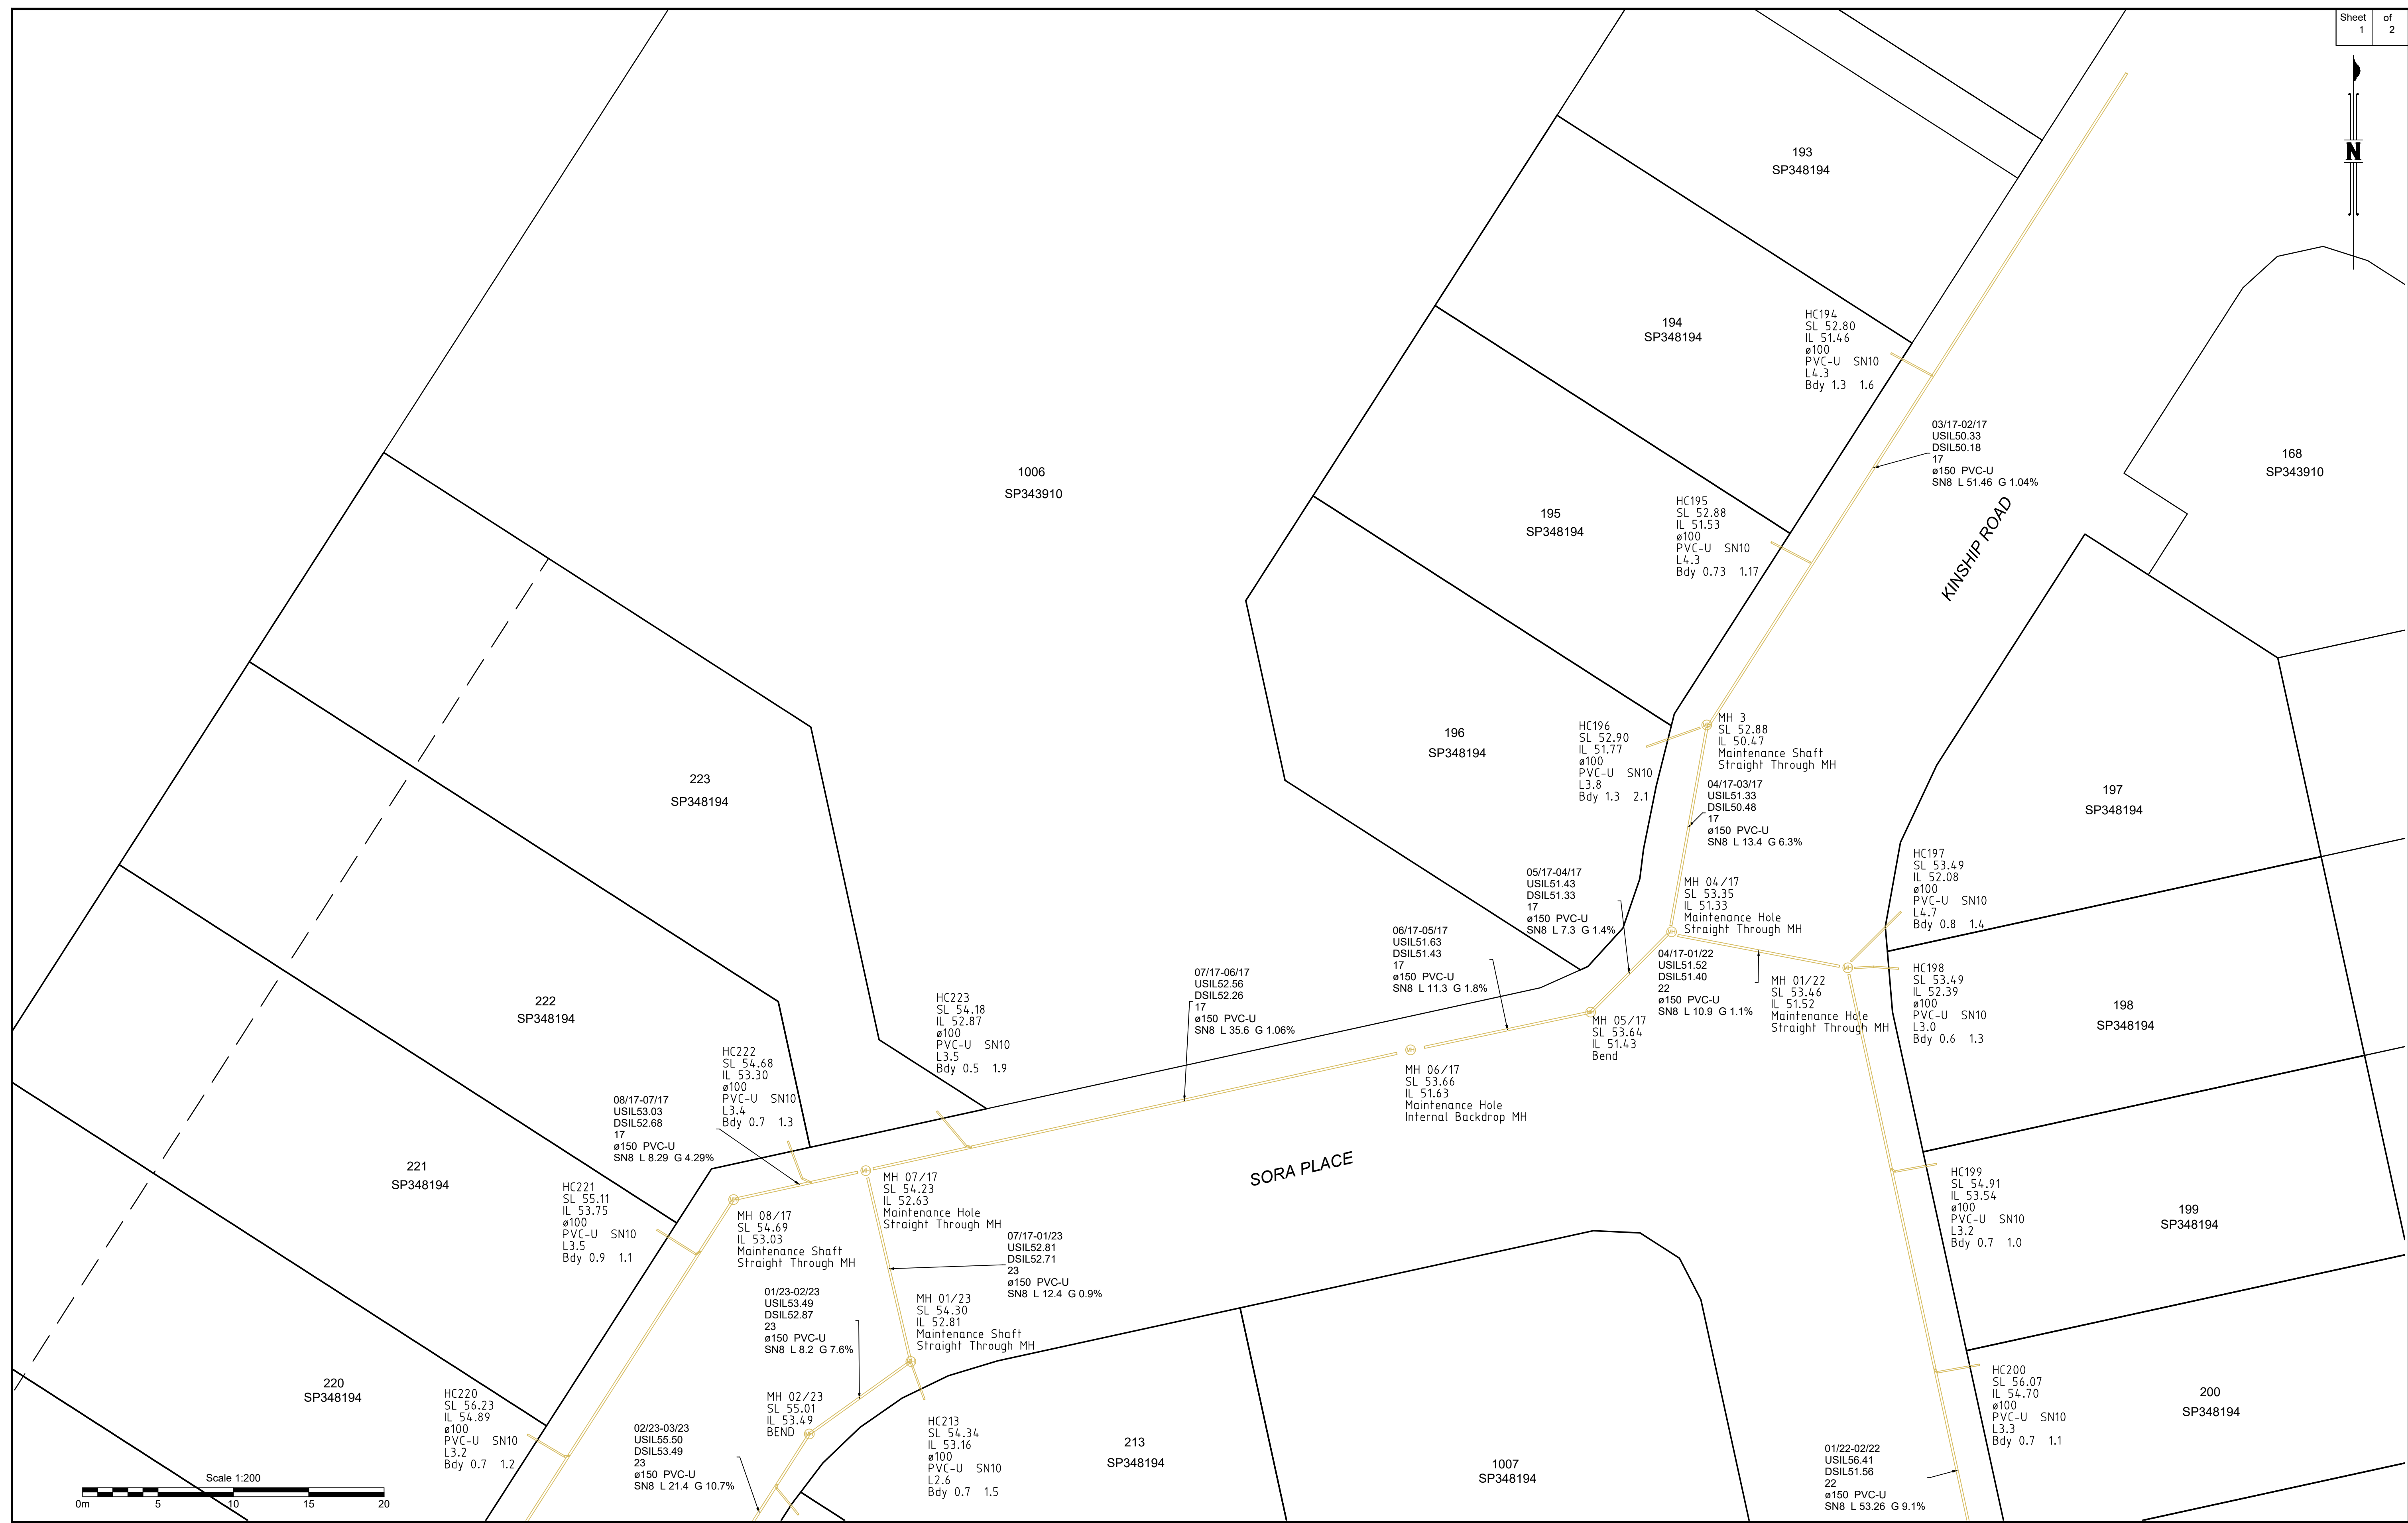


B.B.H PTY. LTD ACN 010 427 531
(trading as Bennett and Bennett Group) hereby certify
that the vertical and horizontal locations, and
dimensions shown on this plan are a true and
correct record of the As-Constructed information.

Agent
Date

I,
hereby certify that the As Constructed
information shown on this plan is a true and
correct record of sizes, types, materials,
classes etc, and it corresponds with the
relevant approved Engineering Drawings

Signed
RPEQ No. Date

Revisions			
Rev	Description	Date	Initial
A	ORIGINAL	25/09/2025	DK


SEWER - AS CONSTRUCTED
COURTNEY DRIVE - STAGE 3
UPPER COOMERA
OPW/2023/1350

Client:	HB Australia Pty Ltd
Job No:	171101
Authority:	Council of the City of Gold Coast
Plan No:	171101_046_ASC.pdf
DWG File:	171101_046_ASC.dwg
Level Origin & Datum:	PSM170053 41.380 AHD
1:200 @ A1	Drawn: DK
Date:	02/10/25



BENNETT + BENNETT

PO Box 5021, GCMC QLD 9726
Ph: (07) 5631 8000
mail@bennettandbennett.com.au
www.bennettandbennett.com.au

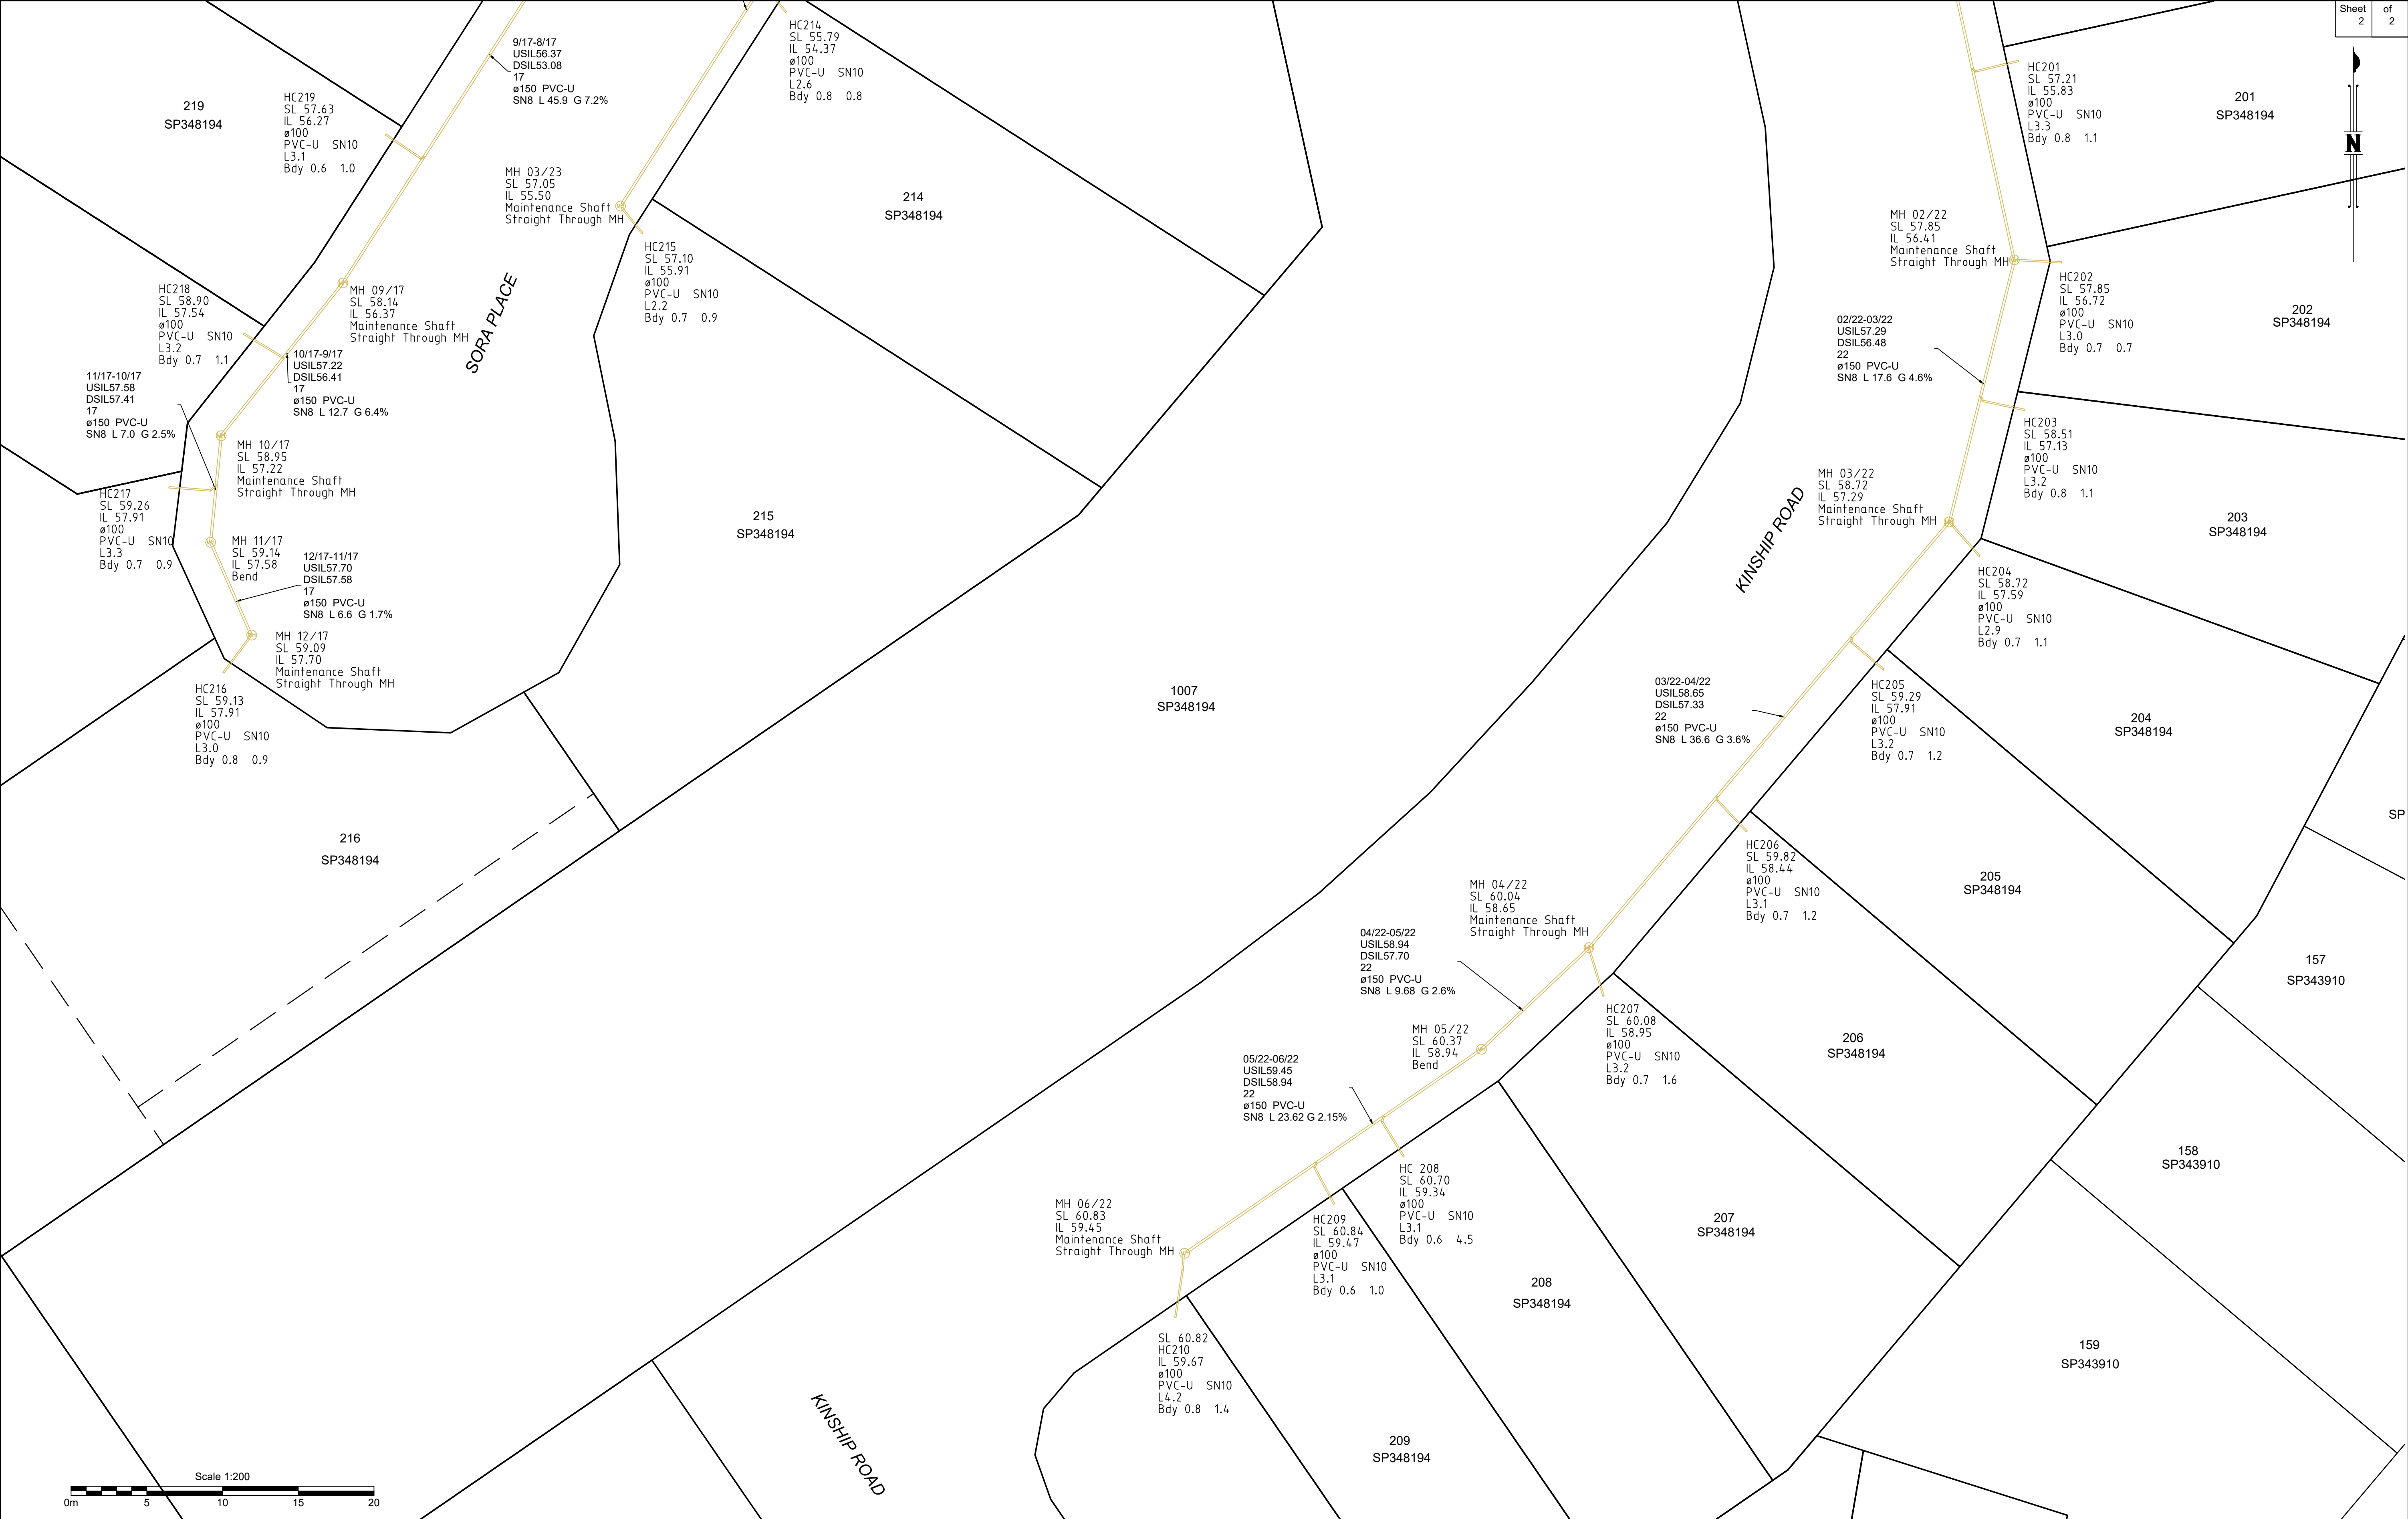

B.B.H PTY. LTD ACN 010 427 531
(trading as Bennett and Bennett Group) hereby certify
that the vertical and horizontal locations, and
dimensions shown on this plan are a true and
correct record of the As-Constructed information.

Agent
Date

I,
hereby certify that the As Constructed
information shown on this plan is a true and
correct record of sizes, types, materials,
classes etc, and it corresponds with the
relevant approved Engineering Drawings

Signed
RPEQ No. Date

Revisions			
Rev	Description	Date	Initial
A	ORIGINAL	25/09/2025	DK

SEWER - AS CONSTRUCTED
COURTNEY DRIVE - STAGE 3
UPPER COOMERA
OPW/2023/1350

Client: HB Australia Pty Ltd	
Job No: 171101	
Authority: Council of the City of Gold Coast	
Plan No: 171101_046_ASC.pdf	
DWG File: 171101_046_ASC.dwg	
Level Origin & Datum: PSM170053 41.380 AHD	Drawn: DK
Date: 02/10/25	

BENNETT + BENNETT

PO Box 5021, GCMC QLD 9726
Ph: (07) 5631 8000
mail@bennettandbennett.com.au
www.bennettandbennett.com.au