


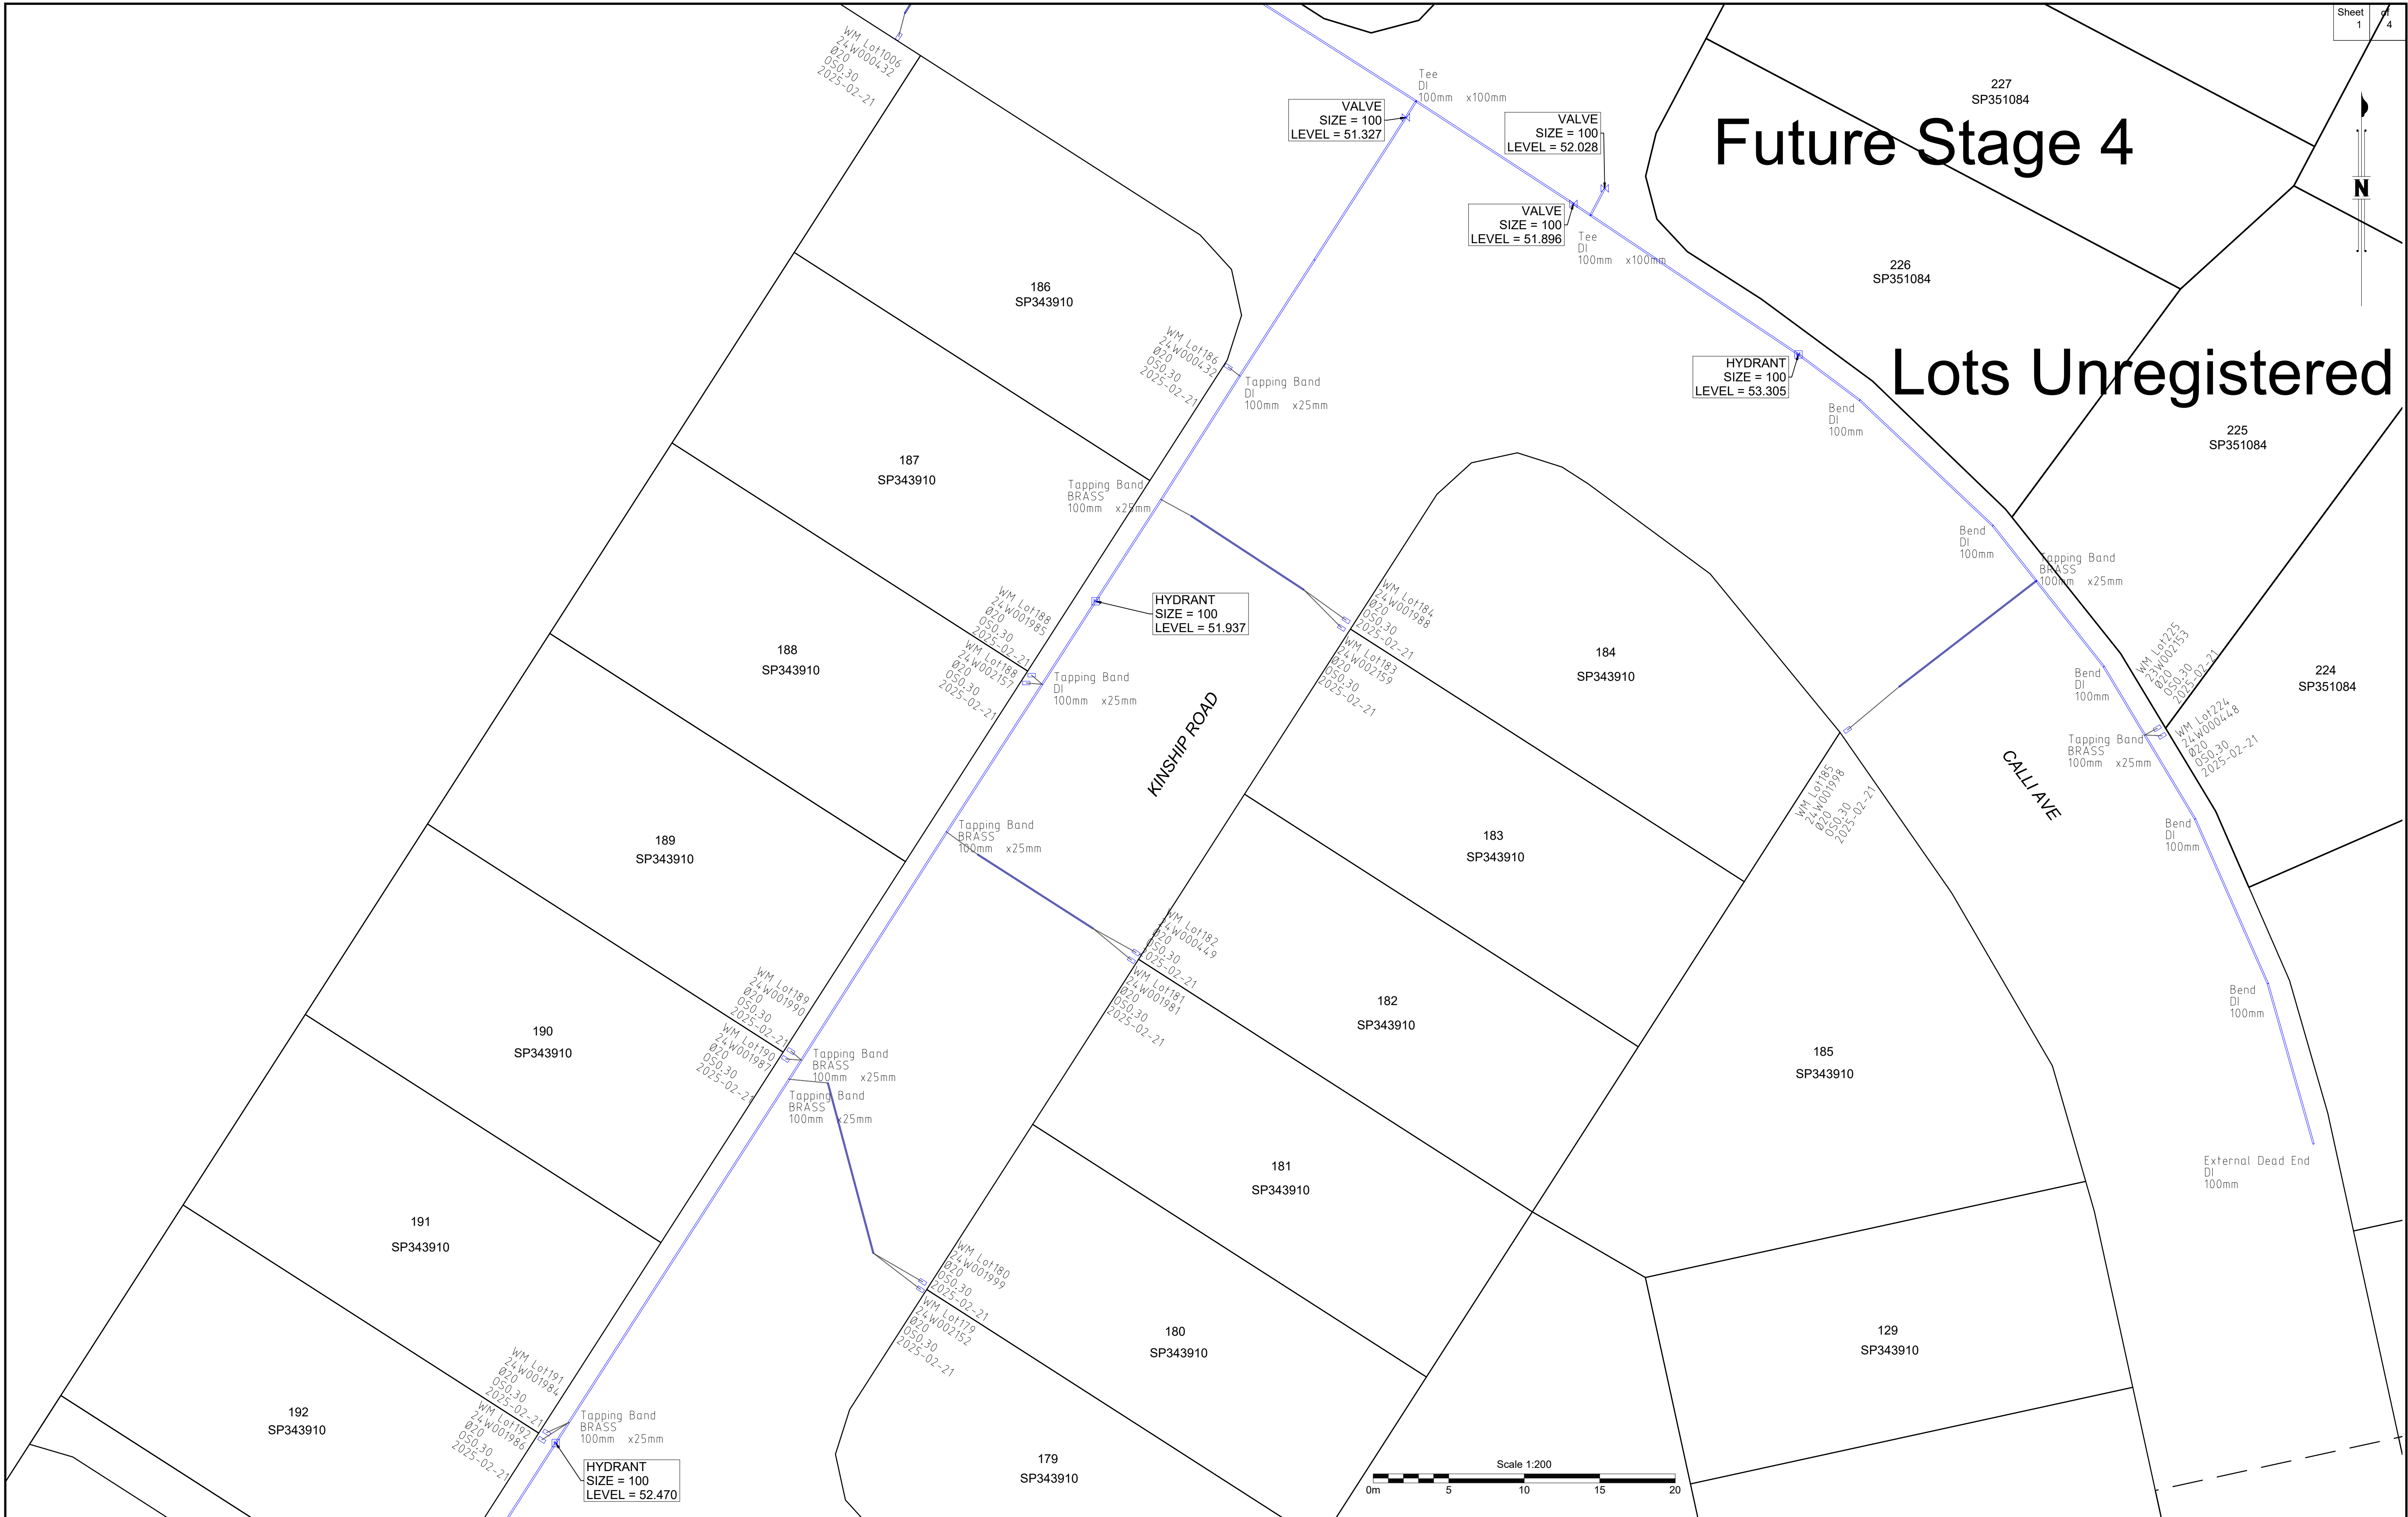

B.B.H PTY. LTD ACN 010 427 531
(trading as Bennett and Bennett Group) hereby certify
that the vertical and horizontal locations, and
dimensions shown on this plan are a true and
correct record of the As-Constructed information.

Agent
Date

I,
hereby certify that the As Constructed
information shown on this plan is a true and
correct record of sizes, types, materials,
classes etc, and it corresponds with the
relevant approved Engineering Drawings

Signed
RPEQ No. Date


Revisions			
Rev	Description	Date	Initial
A	ORIGINAL	09/10/2025	DK

WATER - AS CONSTRUCTED
Courtney Drive - Stage 2
Upper Coomera
OPW/2023/1202

Client:	HB Australia Pty Ltd		
Job No:	171101		
Authority:	Council of the City of Gold Coast		
Plan No:	171101_053_ASC.pdf		
DWG File:	171101_053_ASC.dwg		
Level Origin & Datum:	PSM170053	41.380	AHD
1:200 @ A1	Drawn:	DK	
Date:	09/10/25		

BENNETT + BENNETT

PO Box 5021, GCMC QLD 9726
Ph: (07) 5631 8000
mail@bennettandbennett.com.au
www.bennettandbennett.com.au

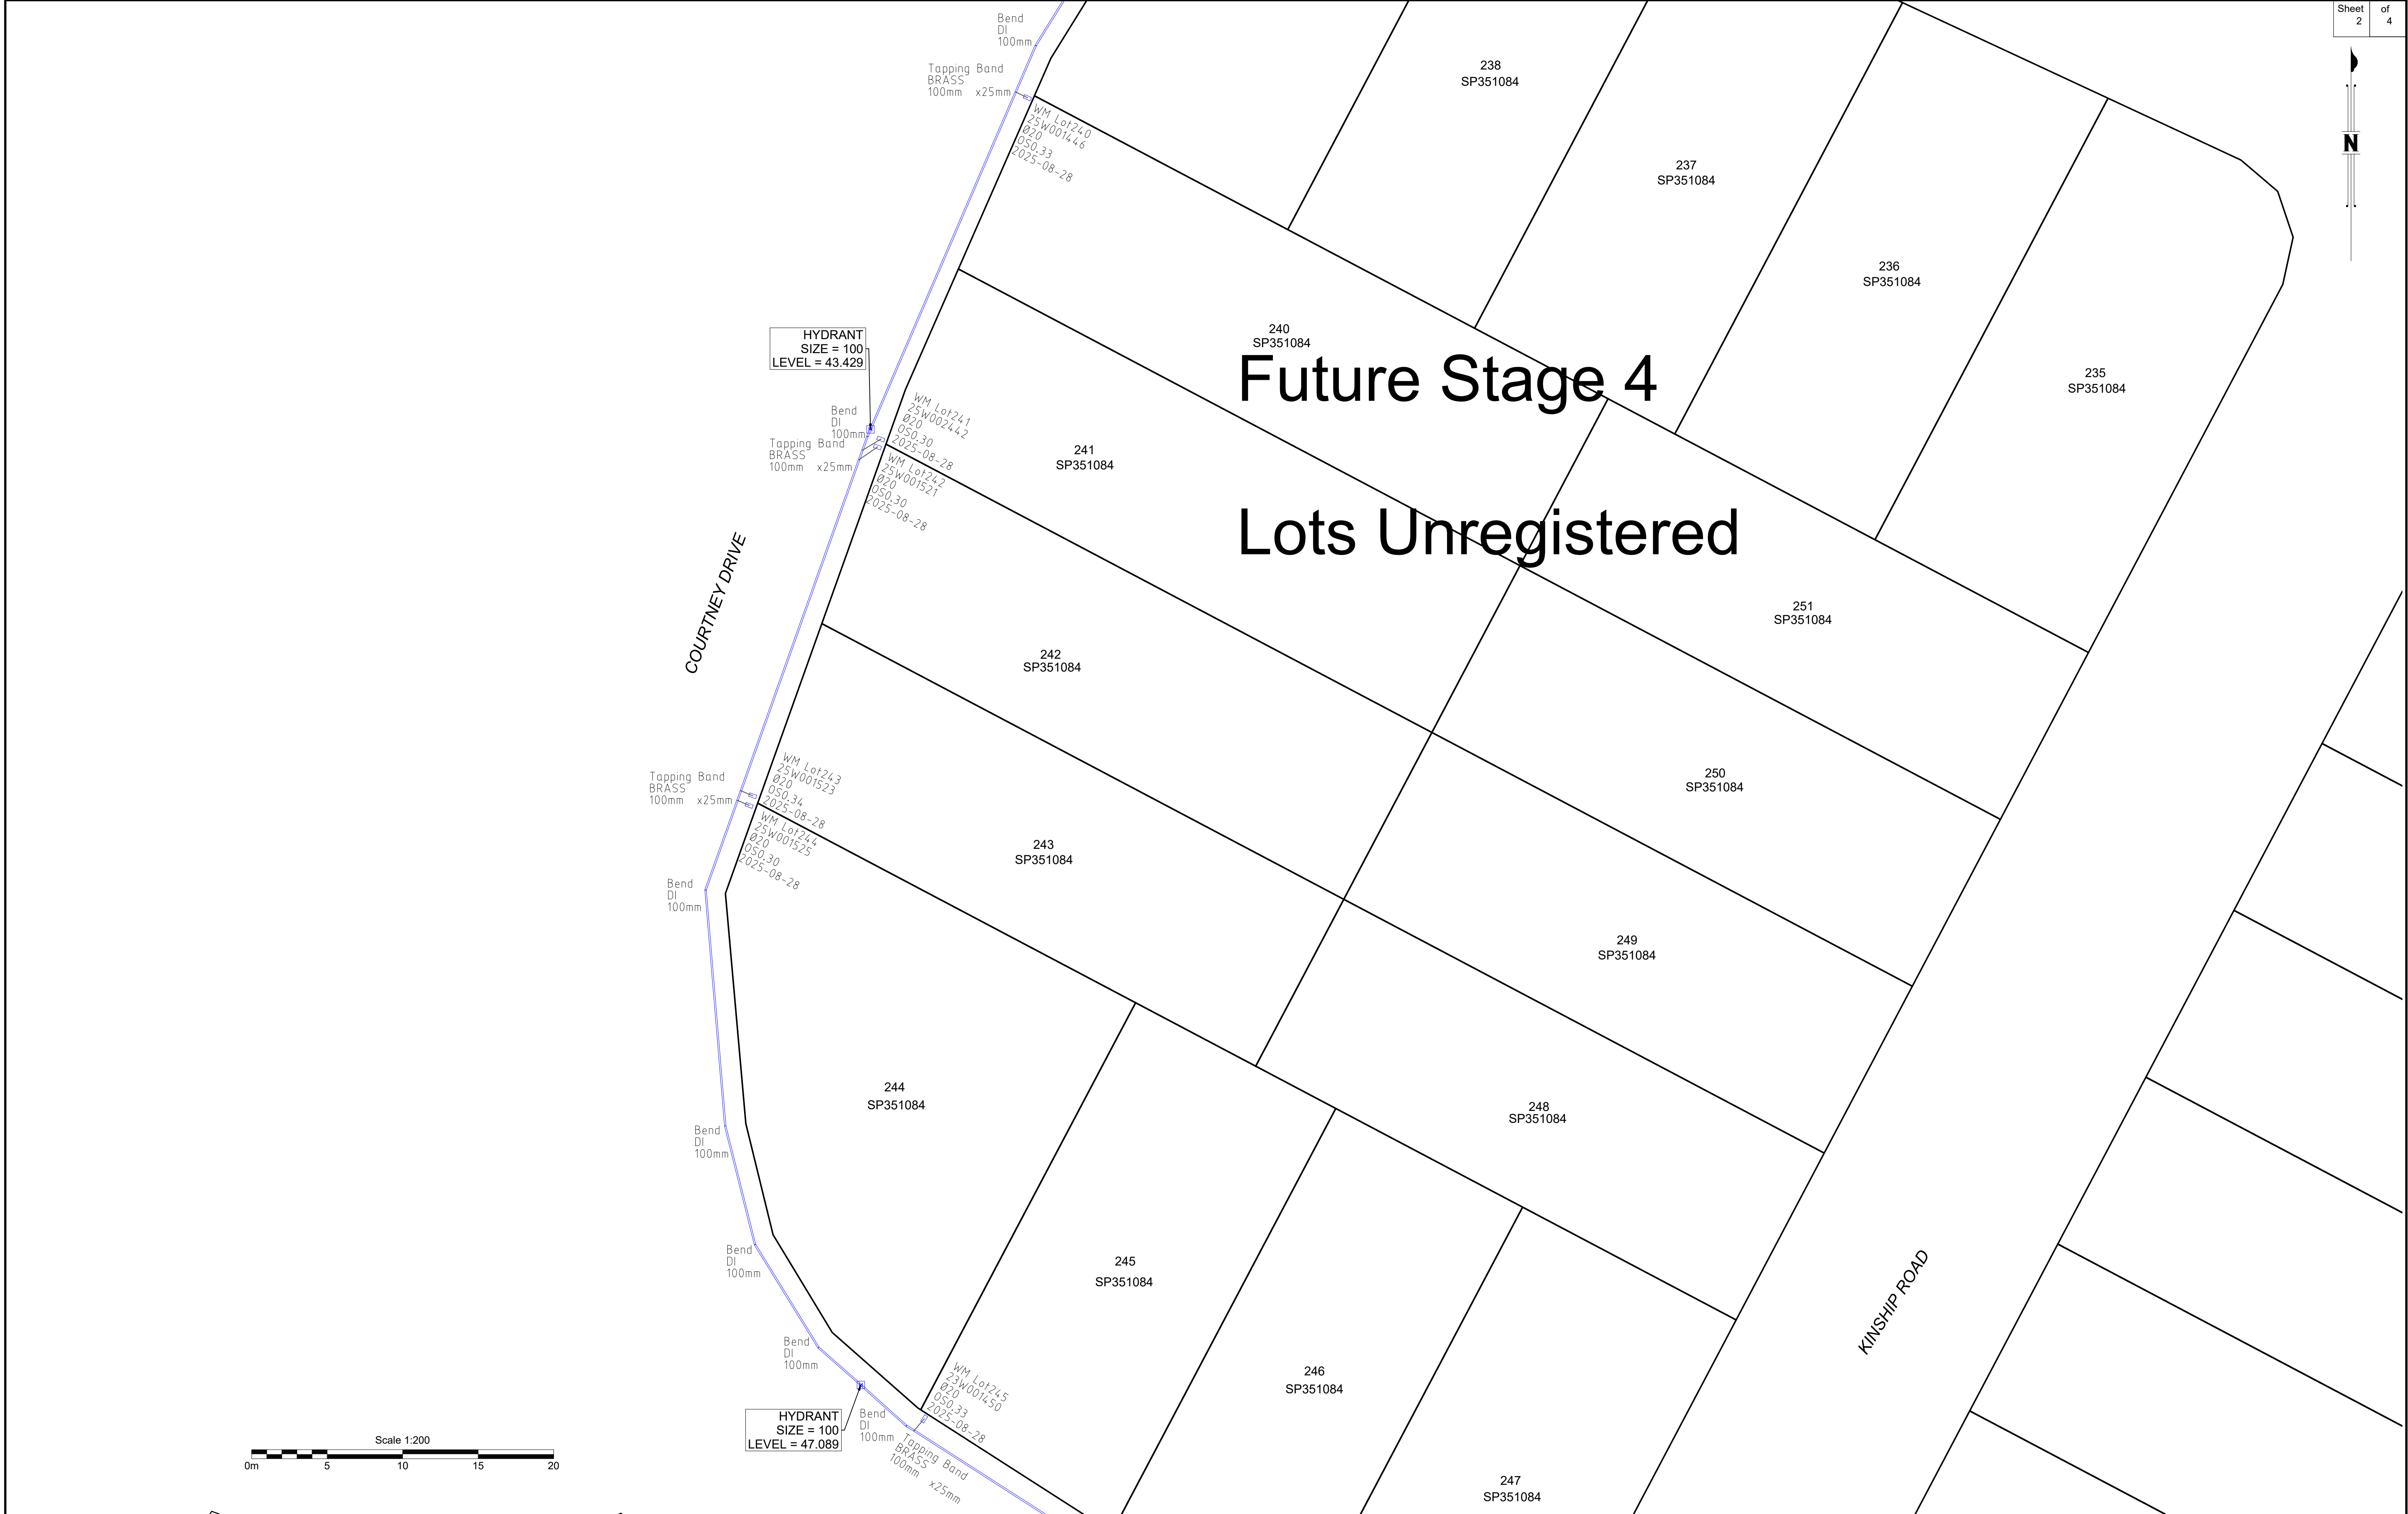

B.B.H PTY. LTD ACN 010 427 531
(trading as Bennett and Bennett Group) hereby certify
that the vertical and horizontal locations, and
dimensions shown on this plan are a true and
correct record of the As-Constructed information.

Agent
Date

I,
hereby certify that the As Constructed
information shown on this plan is a true and
correct record of sizes, types, materials,
classes etc, and it corresponds with the
relevant approved Engineering Drawings

Signed
RPEQ No. Date

Revisions


Rev	Description	Date	Initial
A	ORIGINAL	09/10/2025	DK

WATER - AS CONSTRUCTED
Courtney Drive - Stage 2
Upper Coomera
OPW/2023/1202

Client: HB Australia Pty Ltd	
Job No: 171101	
Authority: Council of the City of Gold Coast	
Plan No: 171101_053_ASC.pdf	
DWG File: 171101_053_ASC.dwg	
Level Origin & Datum:	PSM170053 41.380 AHD
1:200 @ A1	Drawn: DK
Date: 09/10/25	

 **BENNETT + BENNETT**

PO Box 5021, GCMC QLD 9726
Ph: (07) 5631 8000
mail@bennettandbennett.com.au
www.bennettandbennett.com.au

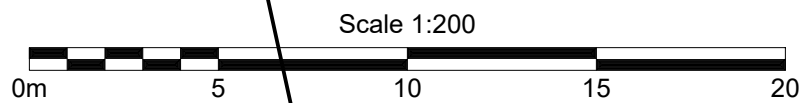

B.B.H PTY. LTD ACN 010 427 531
(trading as Bennett and Bennett Group) hereby certify
that the vertical and horizontal locations, and
dimensions shown on this plan are a true and
correct record of the As-Constructed information.

Agent
Date

I,
hereby certify that the As Constructed
information shown on this plan is a true and
correct record of sizes, types, materials,
classes etc, and it corresponds with the
relevant approved Engineering Drawings

Signed

RPEQ No. Date

Revisions


Rev	Description	Date	Initial
A	ORIGINAL	09/10/2025	DK

WATER - AS CONSTRUCTED
Courtney Drive - Stage 2
Upper Coomera
OPW/2023/1202

Client: HB Australia Pty Ltd	
Job No: 171101	
Authority: Council of the City of Gold Coast	
Plan No: 171101_053_ASC.pdf	
DWG File: 171101_053_ASC.dwg	
Level Origin & Datum:	PSM170053 41.380 AHD
1:200 @ A1	Drawn: DK
Date: 09/10/25	

**BENNETT + BENNETT**

PO Box 5021, GCMC QLD 9726
Ph: (07) 5631 8000
mail@bennettandbennett.com.au
www.bennettandbennett.com.au

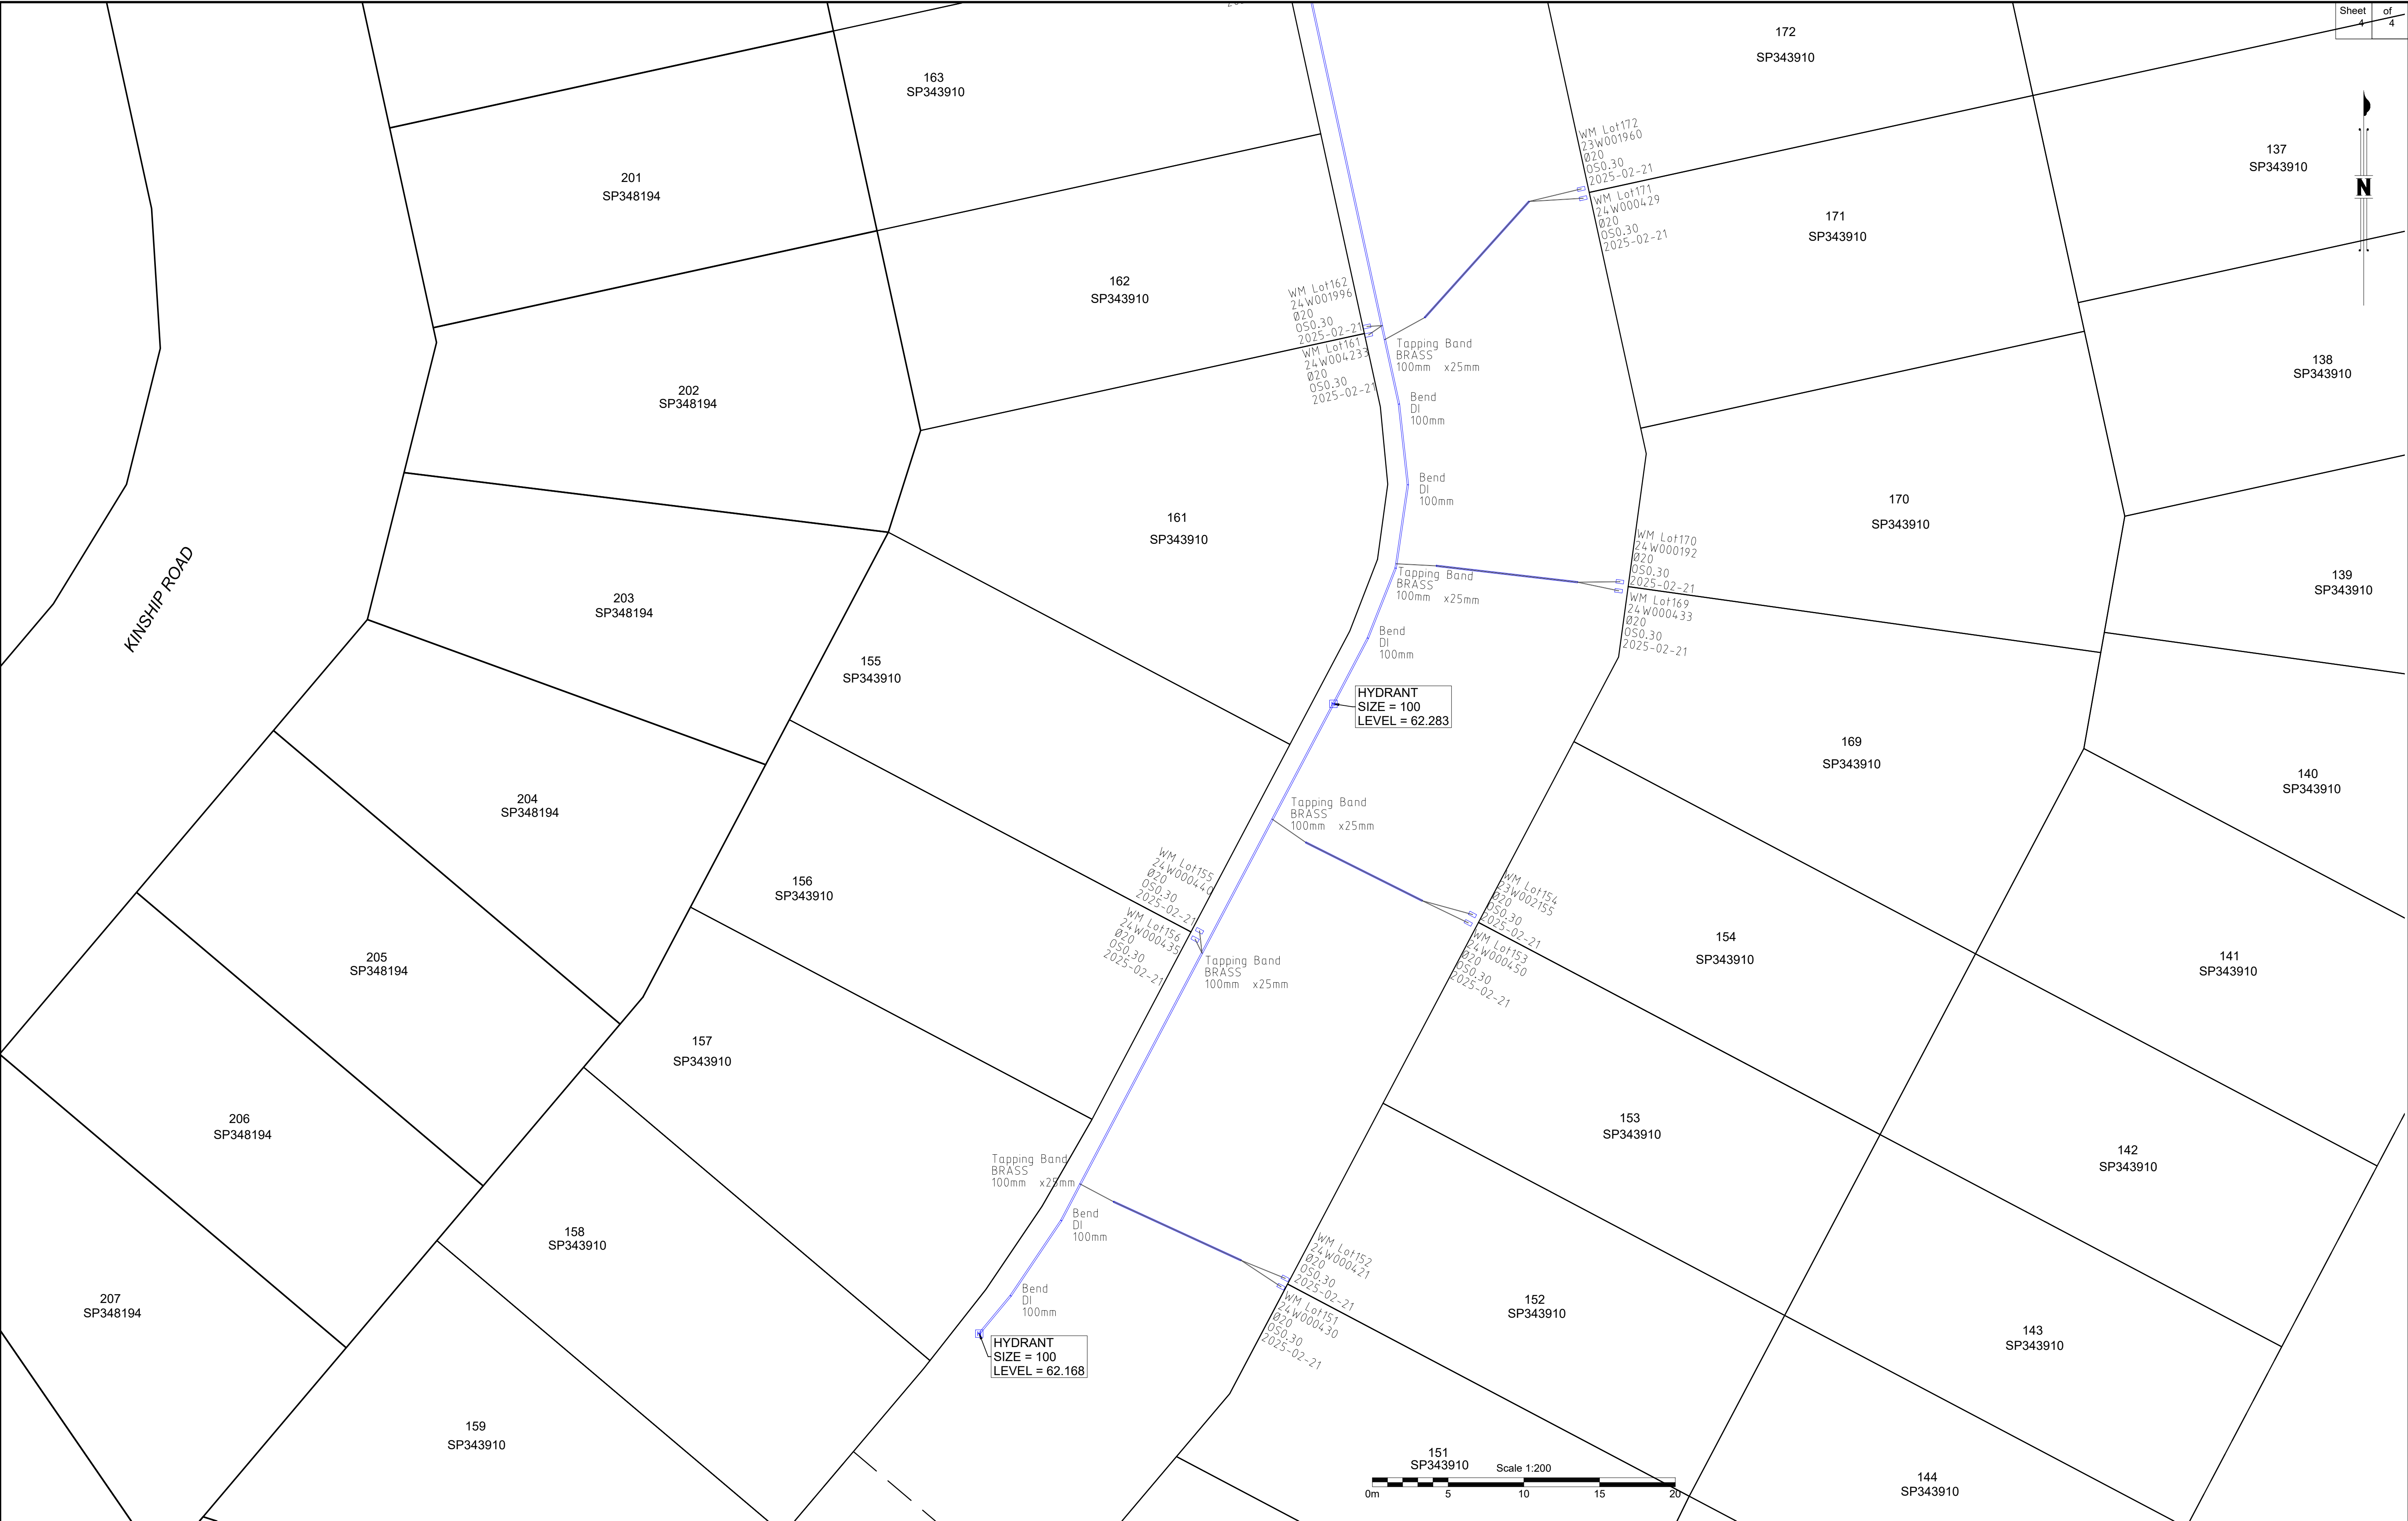

B.B.H.PTY. LTD ACN 010 427 531
(trading as Bennett and Bennett Group) hereby certify
that the vertical and horizontal locations, and
dimensions shown on this plan are a true and
correct record of the As-Constructed information.

.....
Agent

.....
Date

I,
hereby certify that the As Constructed
information shown on this plan is a true and
correct record of sizes, types, materials,
classes etc, and it corresponds with the
relevant approved Engineering Drawings

Signed

RPEQ No. Date

Revisions			
Rev	Description	Date	Initial
A	ORIGINAL	09/10/2025	DK

WATER - AS CONSTRUCTED

Courtenay Drive - Stage 2

Upper Coomera

OPW/2023/1202

Client: HB Australia Pty Ltd	
Job No: 171101	
Authority: Council of the City of Gold Coast	
Plan No: 171101_053_ASC.pdf	
DWG File: 171101_053_ASC.dwg	
Level Origin & Datum:	PSM170053 41.380 AHD
1:200 @ A1	Drawn: DK
Date: 09/10/25	

 **BENNETT + BENNETT**

PO Box 5021, GCMC QLD 9726
Ph: (07) 5631 8000
mail@bennettandbennett.com.au
www.bennettandbennett.com.au